This is a "PROVISIONAL BUILDING PLAN" approved only for the purpose of inviting objections from the general public

DRG NO.	BEST-03

~~ARCHITECT~~ (H.Q.)

S.T.P.
Member Secretary
B.P.C.

S.T.P. (G)
Member
B.P.C.

C.T.P. (Hr.)
Chairman
B.P.C.

Ram Avtar Bassi
AD(HQ)

Checked and found ok for Public Health (Internal) Service only subject to comments in forwarding letter No. SE(HQ) 79868 Dt 6/5/21
Superintending Engineer (HQ)
HSVP, Panchkula

DDT (HQ)
Member
BPAC

JD PA ATP

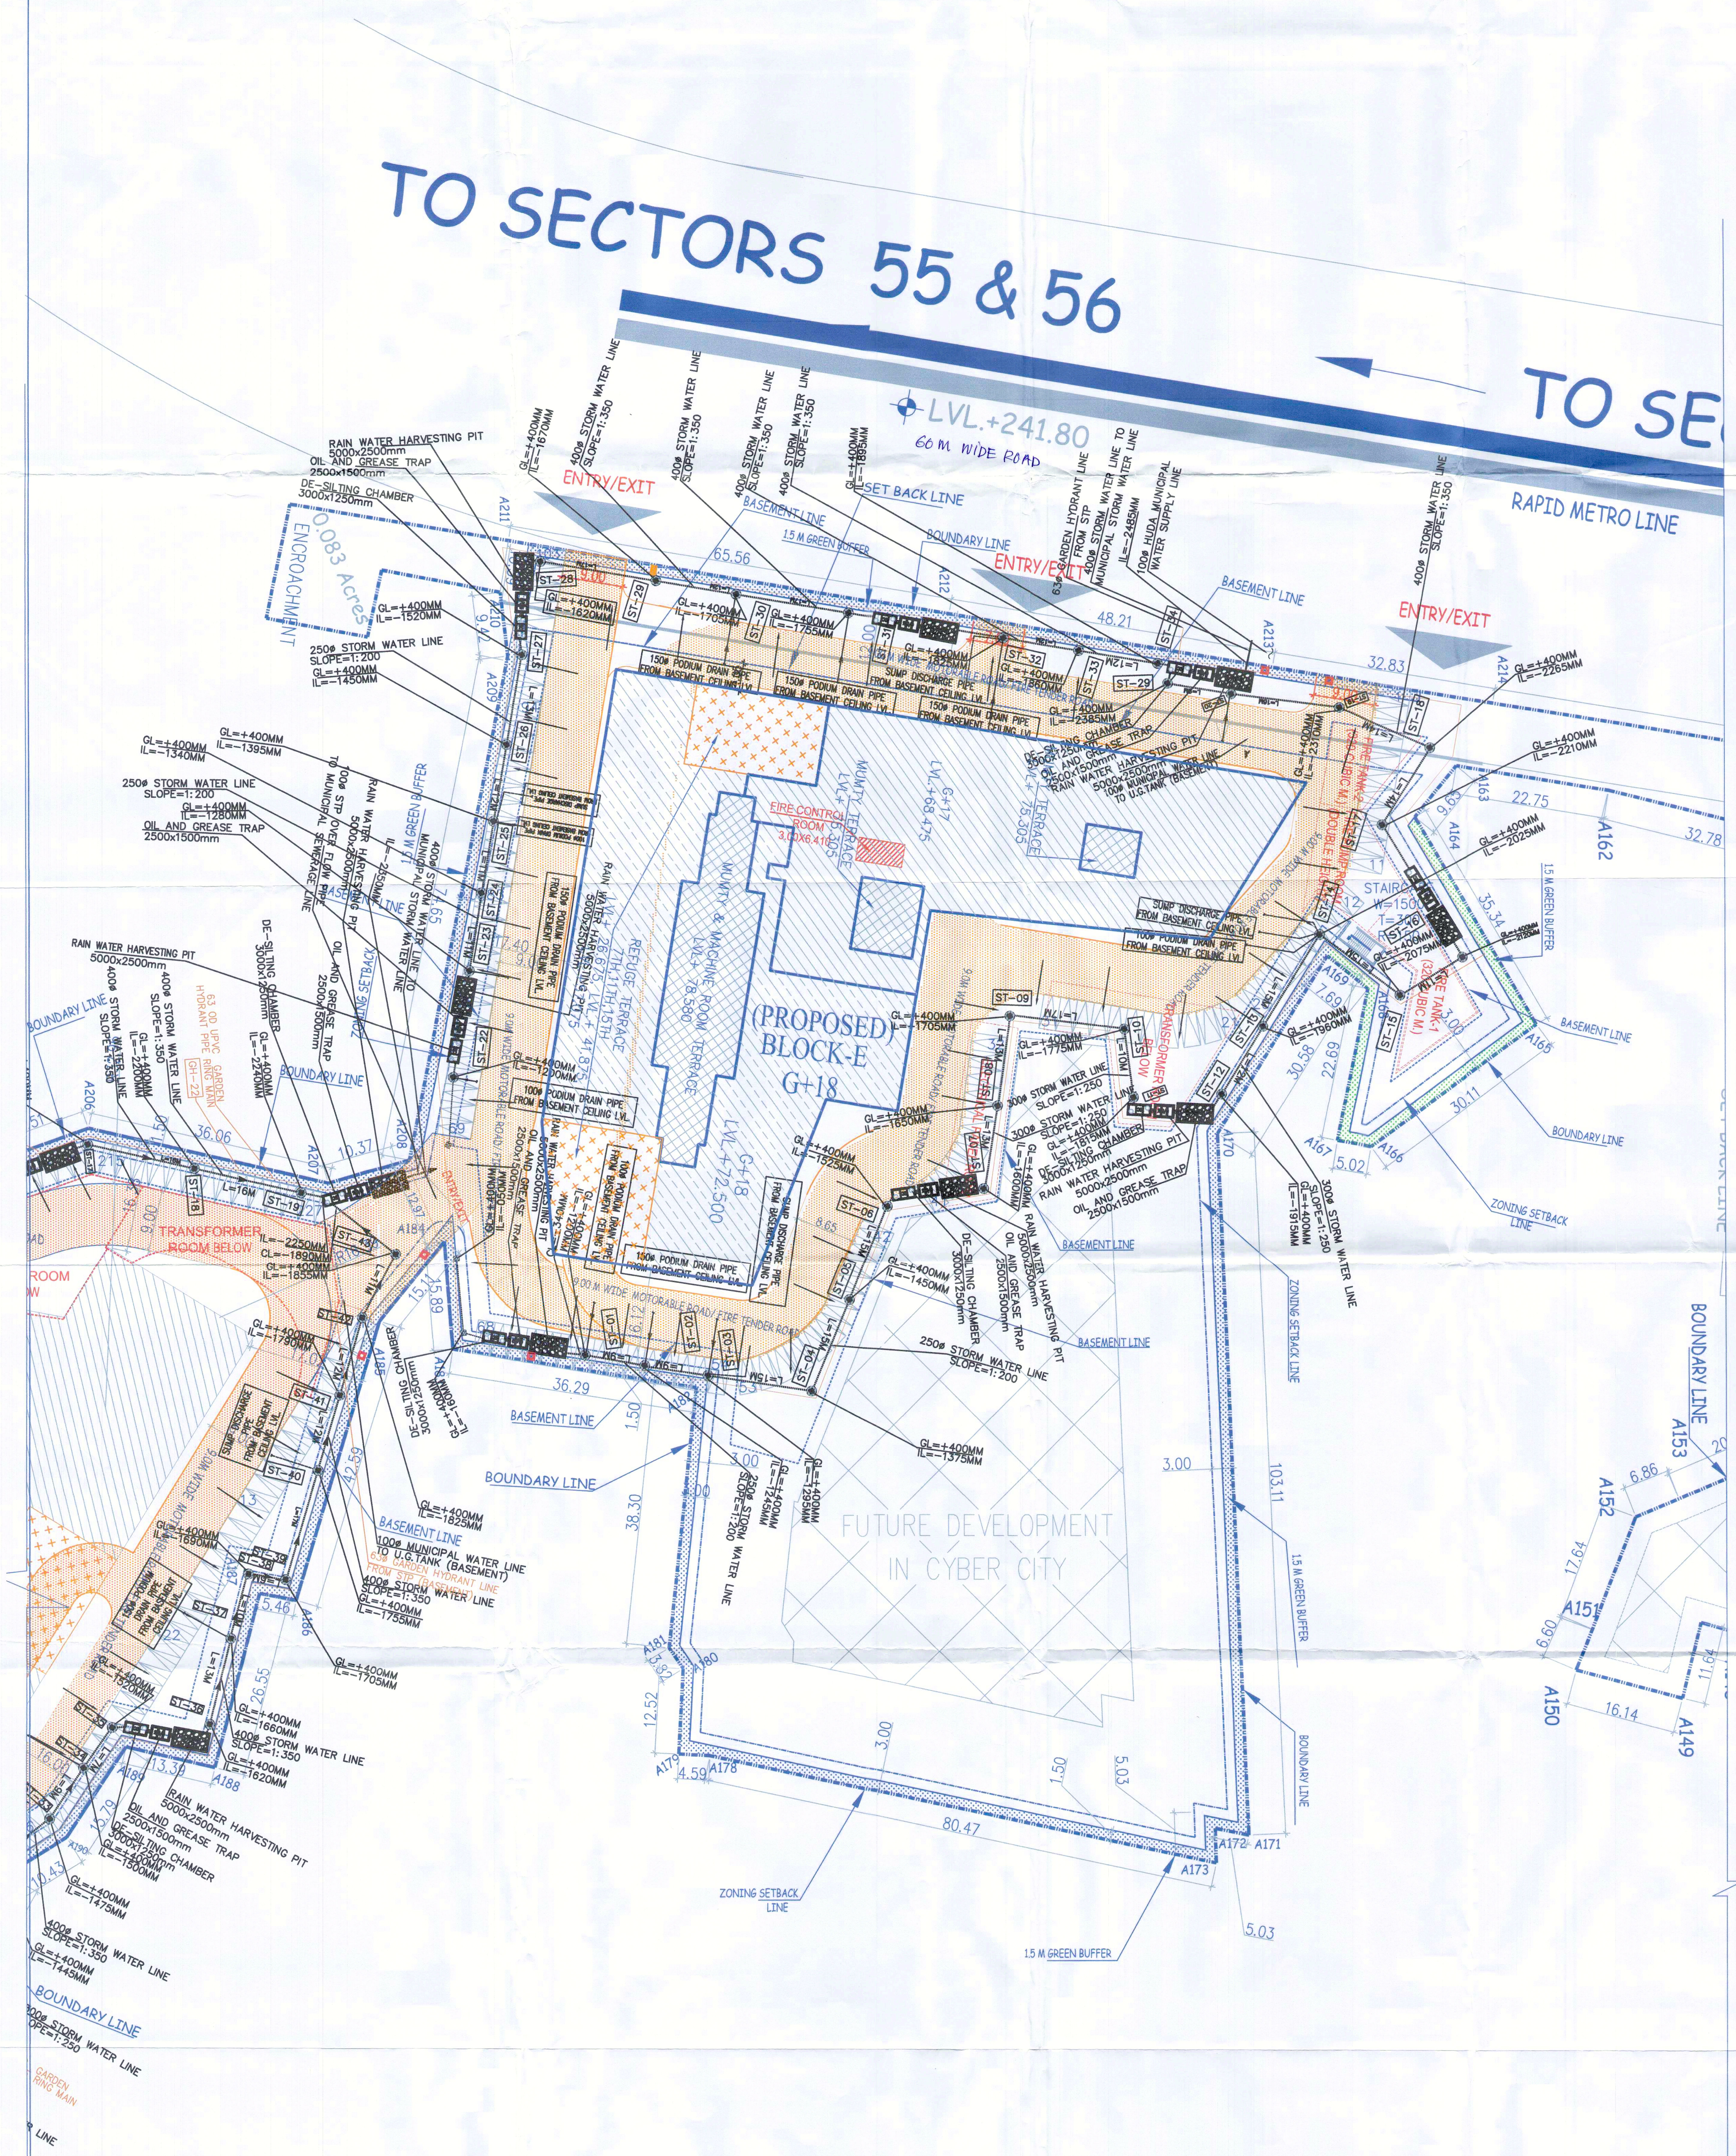
TO SECTORS 55 & 56
TO SE
LVL.+241.80
60 M WIDE ROAD
RAPID METRO LINE
ENTRY/EXIT
ENTRY/EXIT
ENTRY/EXIT
SET BACK LINE
BOUNDARY LINE
BASEMENT LINE
15 M GREEN BUFFER
ZONING SETBACK LINE
(PROPOSED) BLOCK-E G+18
LVL.+72.500
MUMTY & MACHINE ROOM TERRACE
REFUGE TERRACE
FIRE CONTROL ROOM
TERRACE
TRANSFORMER ROOM BELOW
FUTURE DEVELOPMENT IN CYBER CITY
ENCROACHMENT
0.083 Acres
RAIN WATER HARVESTING PIT
OIL AND GREASE TRAP
DE-SILTING CHAMBER
400Ø STORM WATER LINE
250Ø STORM WATER LINE
150Ø PODIUM DRAIN PIPE FROM BASEMENT CEILING LVL
SUMP DISCHARGE PIPE
100Ø MUNICIPAL WATER LINE TO U.G.TANK (BASEMENT)
100Ø HUDA MUNICIPAL WATER SUPPLY LINE
100Ø STP TO MUNICIPAL SEWERAGE LINE
FIRE TANK-1
9.00 M WIDE MOTORABLE ROAD/ FIRE TENDER ROAD
A149
A150
A151
A152
A153
A162
A164
A165
A166
A167
A170
A171
A172
A173
A178
A181
A184
A186
A187
A188
A206
A207
A208
A209
A211
A212
A213
A214
80.47
103.11
36.29
38.30
65.56
48.21
32.83
32.78
22.75
30.11
30.58
22.69
12.52
26.55
42.59
36.06
16.14
17.64
6.86
6.60
3.00
5.03
1.50

KEY PLAN

BLOCK-E

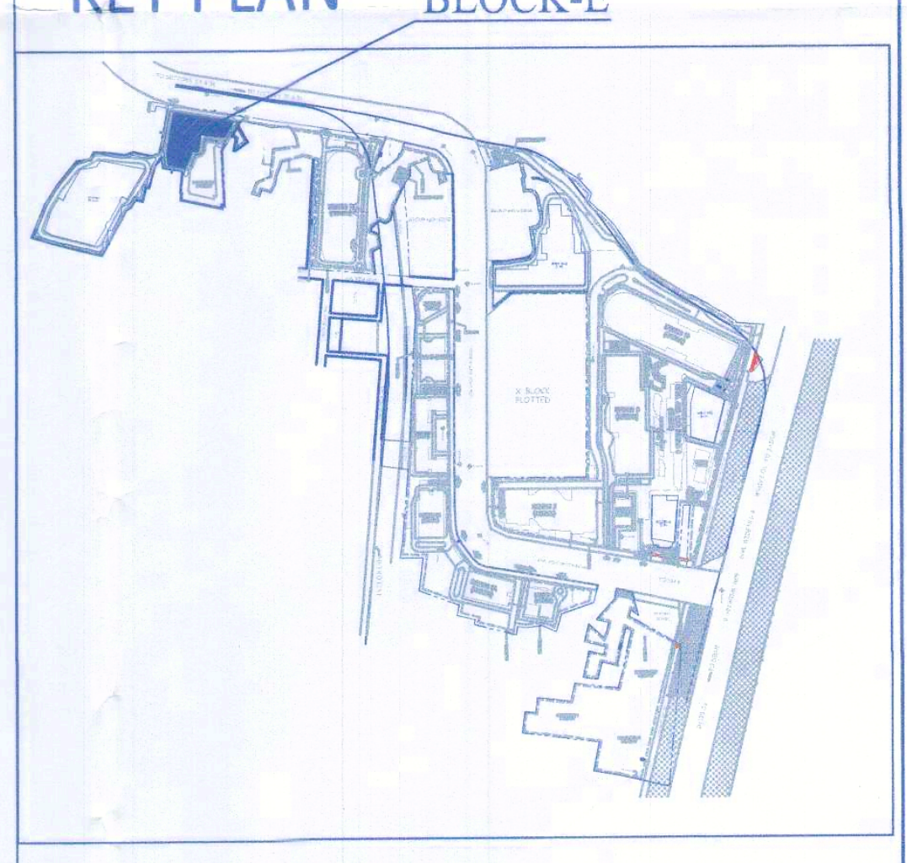

BOUNDARY LINE

Architect
Hafeez
Contractor
29 Bank Street, Bombay 400 023. Tel:2661920

RSMS
ARCHITECTS

RSMS ARCHITECTS PVT. LTD.
69,Nora Niwas Bhawani Kunj
(Behind D2), Vasant Kunj,
~~New Delhi-110070.~~
Tel.:011-26898616,26898617
www.rsms-arch.com

Project:

PROPOSED BUILDING PLANS OF BUILDING – B AND REVISED BUILDING PLANS OF BUILDING–C, D, E, & F IN CYBER CITY UNDER TRANSIT ORIENTED DEVELOPMENT (TOD)POLICY FOR MIX LAND USED COLONY(70% IT/ITES/+30% COMMERCIAL) MEASURING 108.55922 ACRES IN SECTOR 24, 25 & 25–A, GURUGRAM MANESAR URBAN COMPLEX BEING DEVELOPED BY DLF CYBER CITY DEVELOPERS LIMITED

OWNER: DLF

DLF Cyber City Developers Ltd.
10th Floor DLF Gateway Tower,
DLF Cyber City, Gurugram,
Haryana Pin:122002

DRAWING TITLE: –

BLOCK-E
SITE PLAN
(STORM WATER SCHEME)

REVISION	JOB NO:–	DRG NO. BEST-03	NORTH:–
	SCALE:– 1:500	DATE:– 01–04–2021	
FILE:–	DEALT BY:–	CHECKED BY:	APPROVED BY:–

ARCHITECT'S SEAL & SIGNATURE

OWNER'S SEAL & SIGNATURE

DLF Cyber City Developers Ltd.